


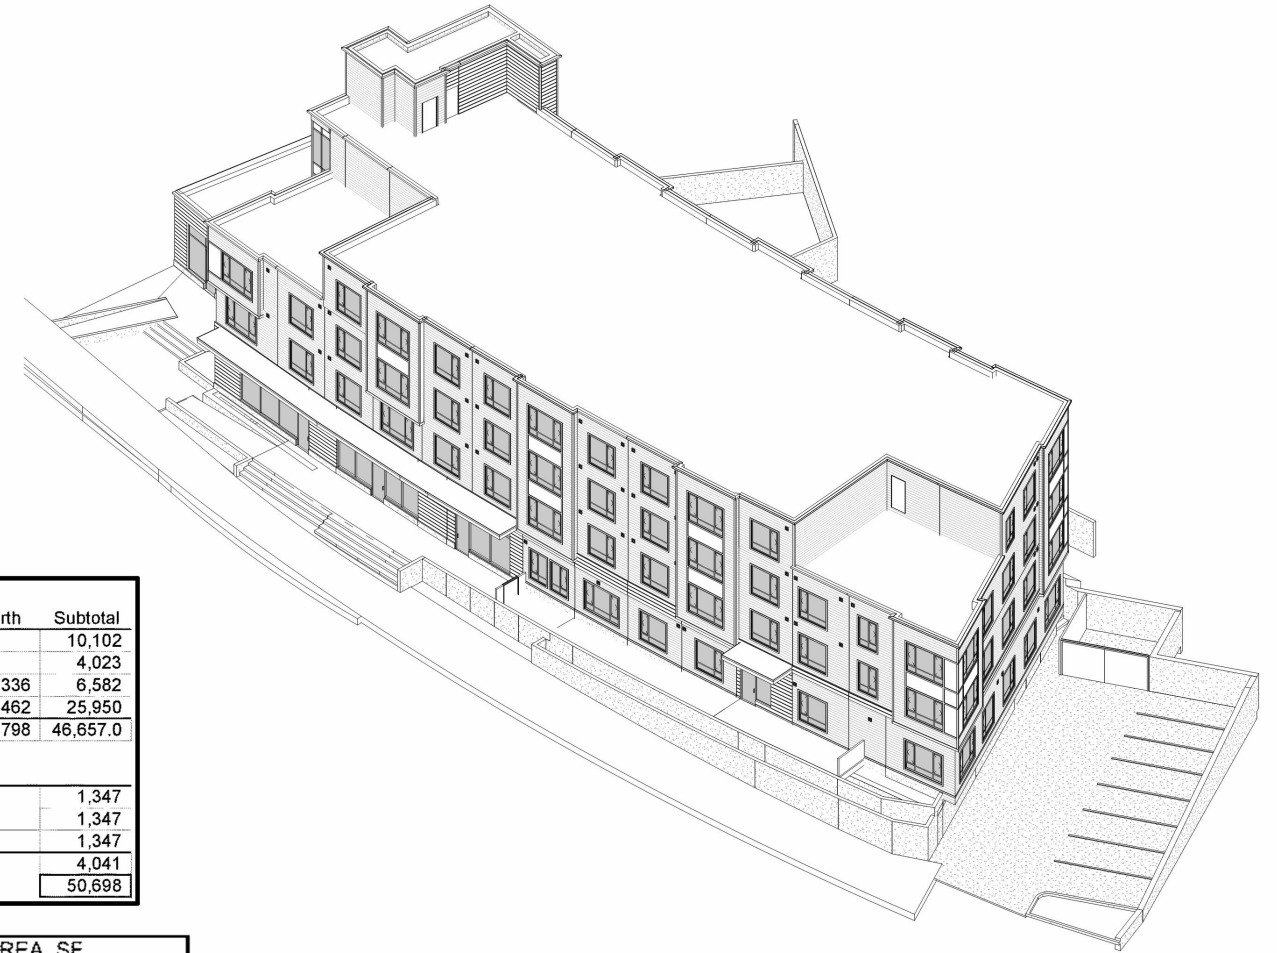


Built Areas	(Gross Square Feet)					
<i>Mixed Use Building</i>	Basement	First	Second	Third	Fourth	Subtotal
Parking garage	10,102					10,102
Retail		4,023				4,023
Residential, common		2,588	1,329	1,329	1,336	6,582
Residential, Units		3,675	7,822	7,991	6,462	25,950
Total GSF	10,102	10,286	9,151	9,320	7,798	46,657.0
<i>Townhouses</i>						
Unit A, 3BR						1,347
Unit B, 3BR						1,347
Unit C, 3BR						1,347
						4,041
Total Built Area						50,698

FAR CALCULATION	AREA, SF
Total Built Area GSF	50,698
Areas excluded for FAR calculation	
Basement parking garage & utility areas	(10,102)
First floor boiler room & laundry room	(364)
Elevator shaft	(360)
First floor storage room	(60)
Plumbing chases	(120)
Net Area for FAR	39,692

TABULATION OF ZONING REQUIREMENTS

Consolidated Site	Current Zoning	Proposed Development	Compliance Status
10-22 Bowdoin Street and 32 Bowdoin Street			
Zoning Sub-District for 10-22 Bowdoin	LC Local Convenience - Neighborhood Business Subdistrict		
Zoning Sub-District for 32 Bowdoin	3-Family Residential 3F-5000		
Primary Uses	Retail, Multifamily Conditional Allows uses normally incident to primary use	Retail, Multifamily Parking on 32 Bowdoin	Relief required for multifamily Relief may be required for 32 Bowdoin
Accessory Uses			
FAR	1	1.41	Relief required
Max Building Height	40	48.33	Relief required
Minimum lot size	none	28,157	N/A
Minimum lot area per dwelling unit	none	804	N/A
Minimum usable Open Space, SF/Dwelling Unit	50	382	OK
Minimum lot width	none	n/a	N/A
Min Lot Frontage	none	n/a	N/A
Min Front Yard	none	252.5	N/A
Min Side Yard	none	0	N/A
Min Rear Yard	20 ft.	26	OK
Planted buffer at parking adjacent to residential abutters	5 ft.	7'-3" not planted	Relief required
On Site Parking Spaces, Retail 2/1000 SF	8	11	OK
On Site Parking Spaces, Residential 1.5/unit	53	25	Relief required
Off Street Loading Spaces	1	1	OK

Notes: Please see letter from Goulston & Storrs PC accompanying this building permit application for more information on zoning

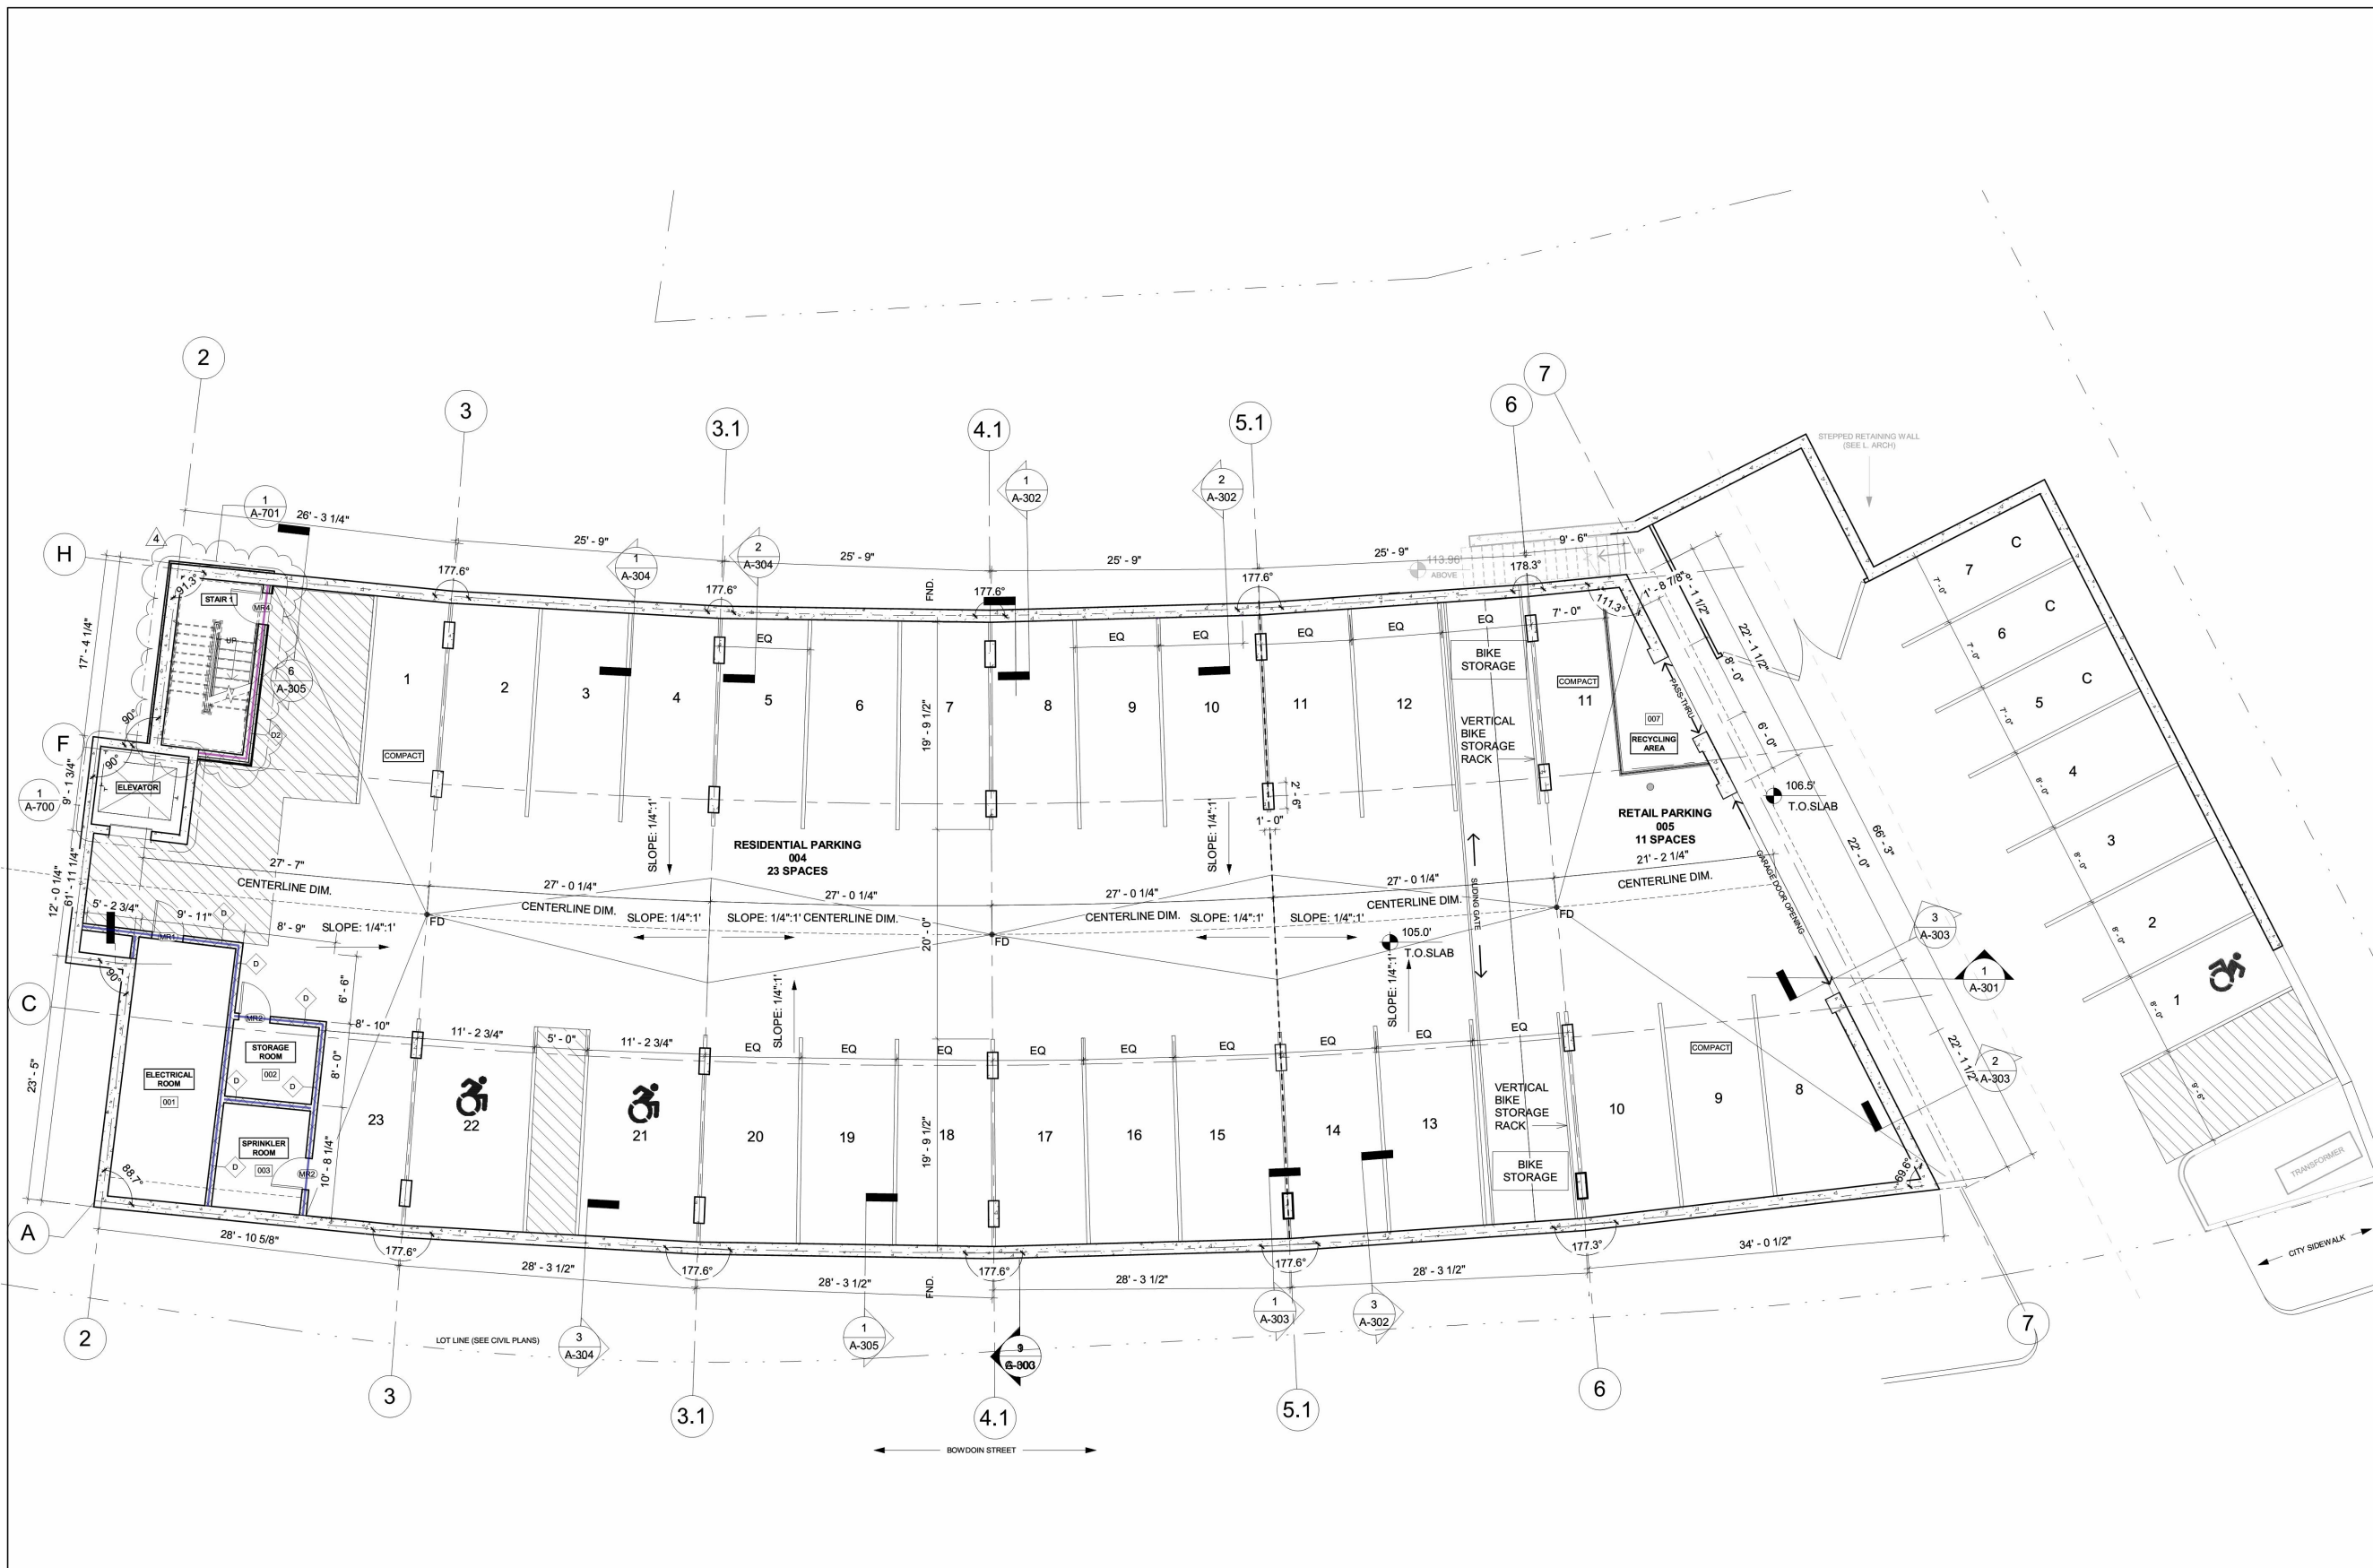

Basement/Garage Level

Type D Masonry wall, 7' High, 01 BB, Ded=3 x (3 x 6.67')


Type D2 Masonry wall, 8.33' High, 01 BB, Ded=1 x (3 x 6.67')

1.0

77.5 FT


21.3 FT


GRAPHIC LEGEND	(NOT ALL GRAPHICS SHOWN)	WALL DIMENSIONING (UNLESS OTHERWISE NOTED)
AREA OF STRIPING		CENTERLINE DIMENSIONS STUD TO STUD DIMENSIONS

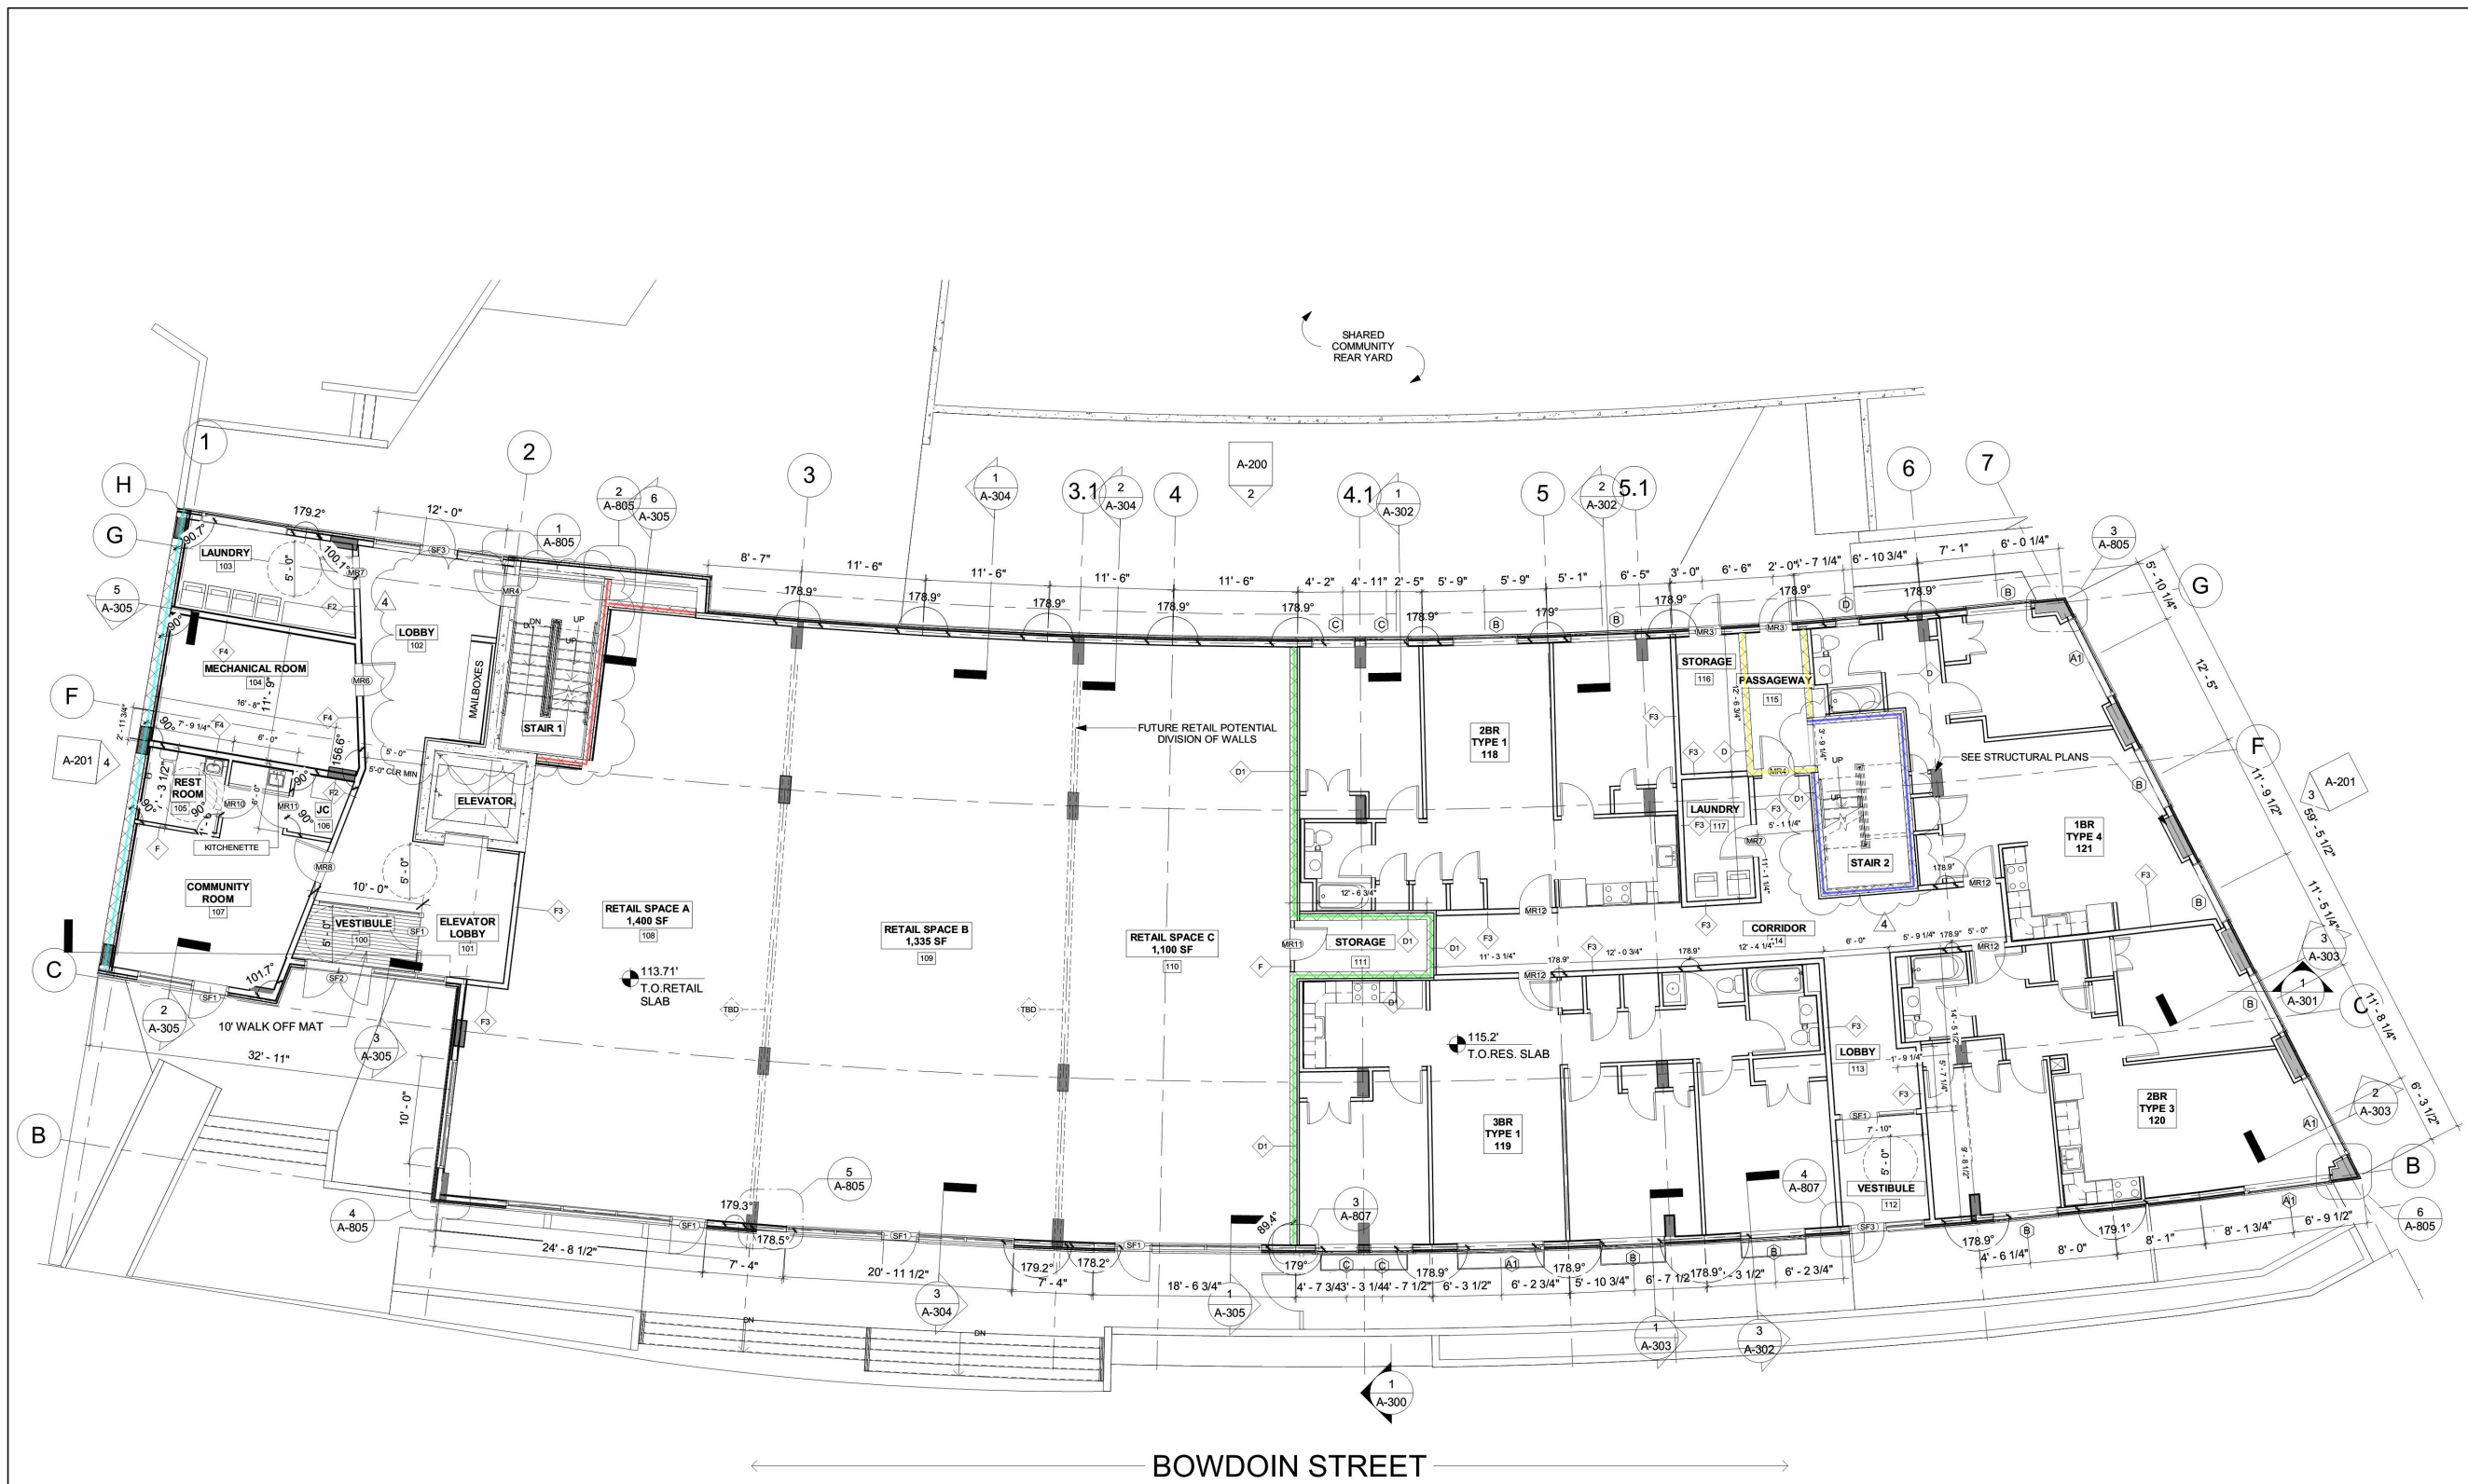

- 1st floor
- Type D2 Masonry wall, 13.67' High, 01 BB, Ded=3 x (3 x 6.67')
- Type D1 Masonry wall, 10.83' High, 01 BB, Ded= 1 x (3 x 6.67')
- Type D Masonry wall, 10.73' High, 01 BB, Ded=1 x (3 x 6.67')
- Type D2 Masonry wall, 10.83' High, 01 BB
- 12" CMU Masonry wall, 13.33' High, 01 BB

- 1.0
- 29.8 FT
- 80.0 FT
- 27.2 FT
- 44.0 FT
- 42.9 FT

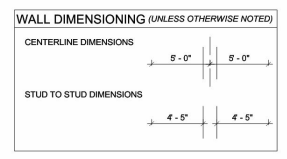

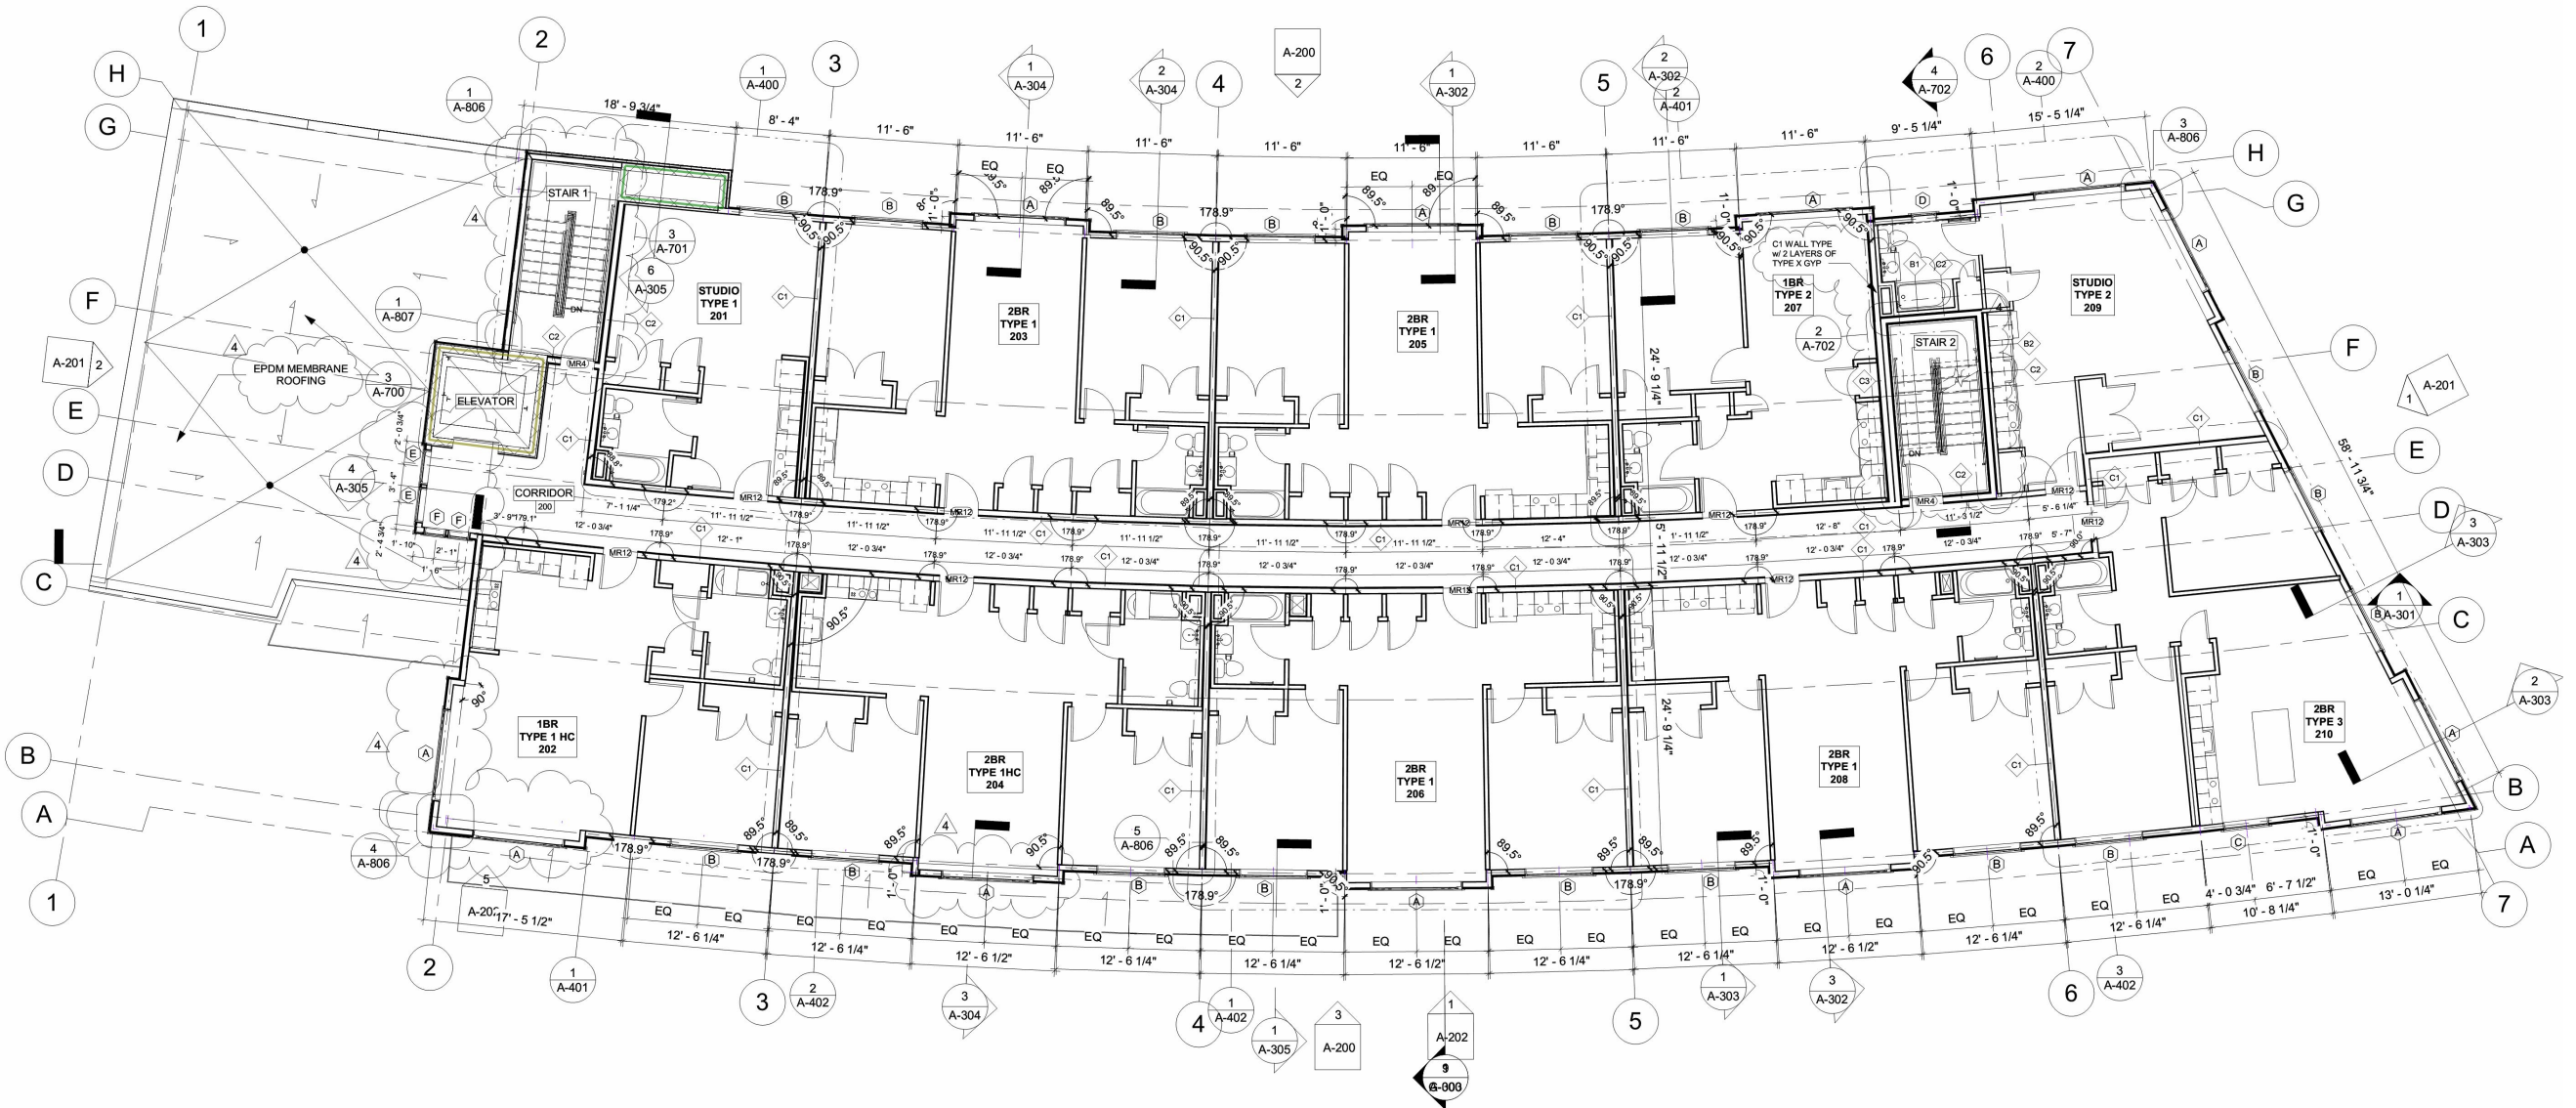

2nd floor to 4th floor & roof


Type D2 Masonry wall, 36' High, 04 BB


8" CMU @ Elevator, Refer: 06/A-700, Ded: As per plan

1.0

23.2 FT


34.7 FT

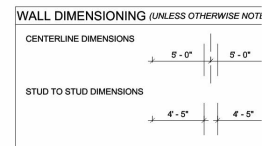

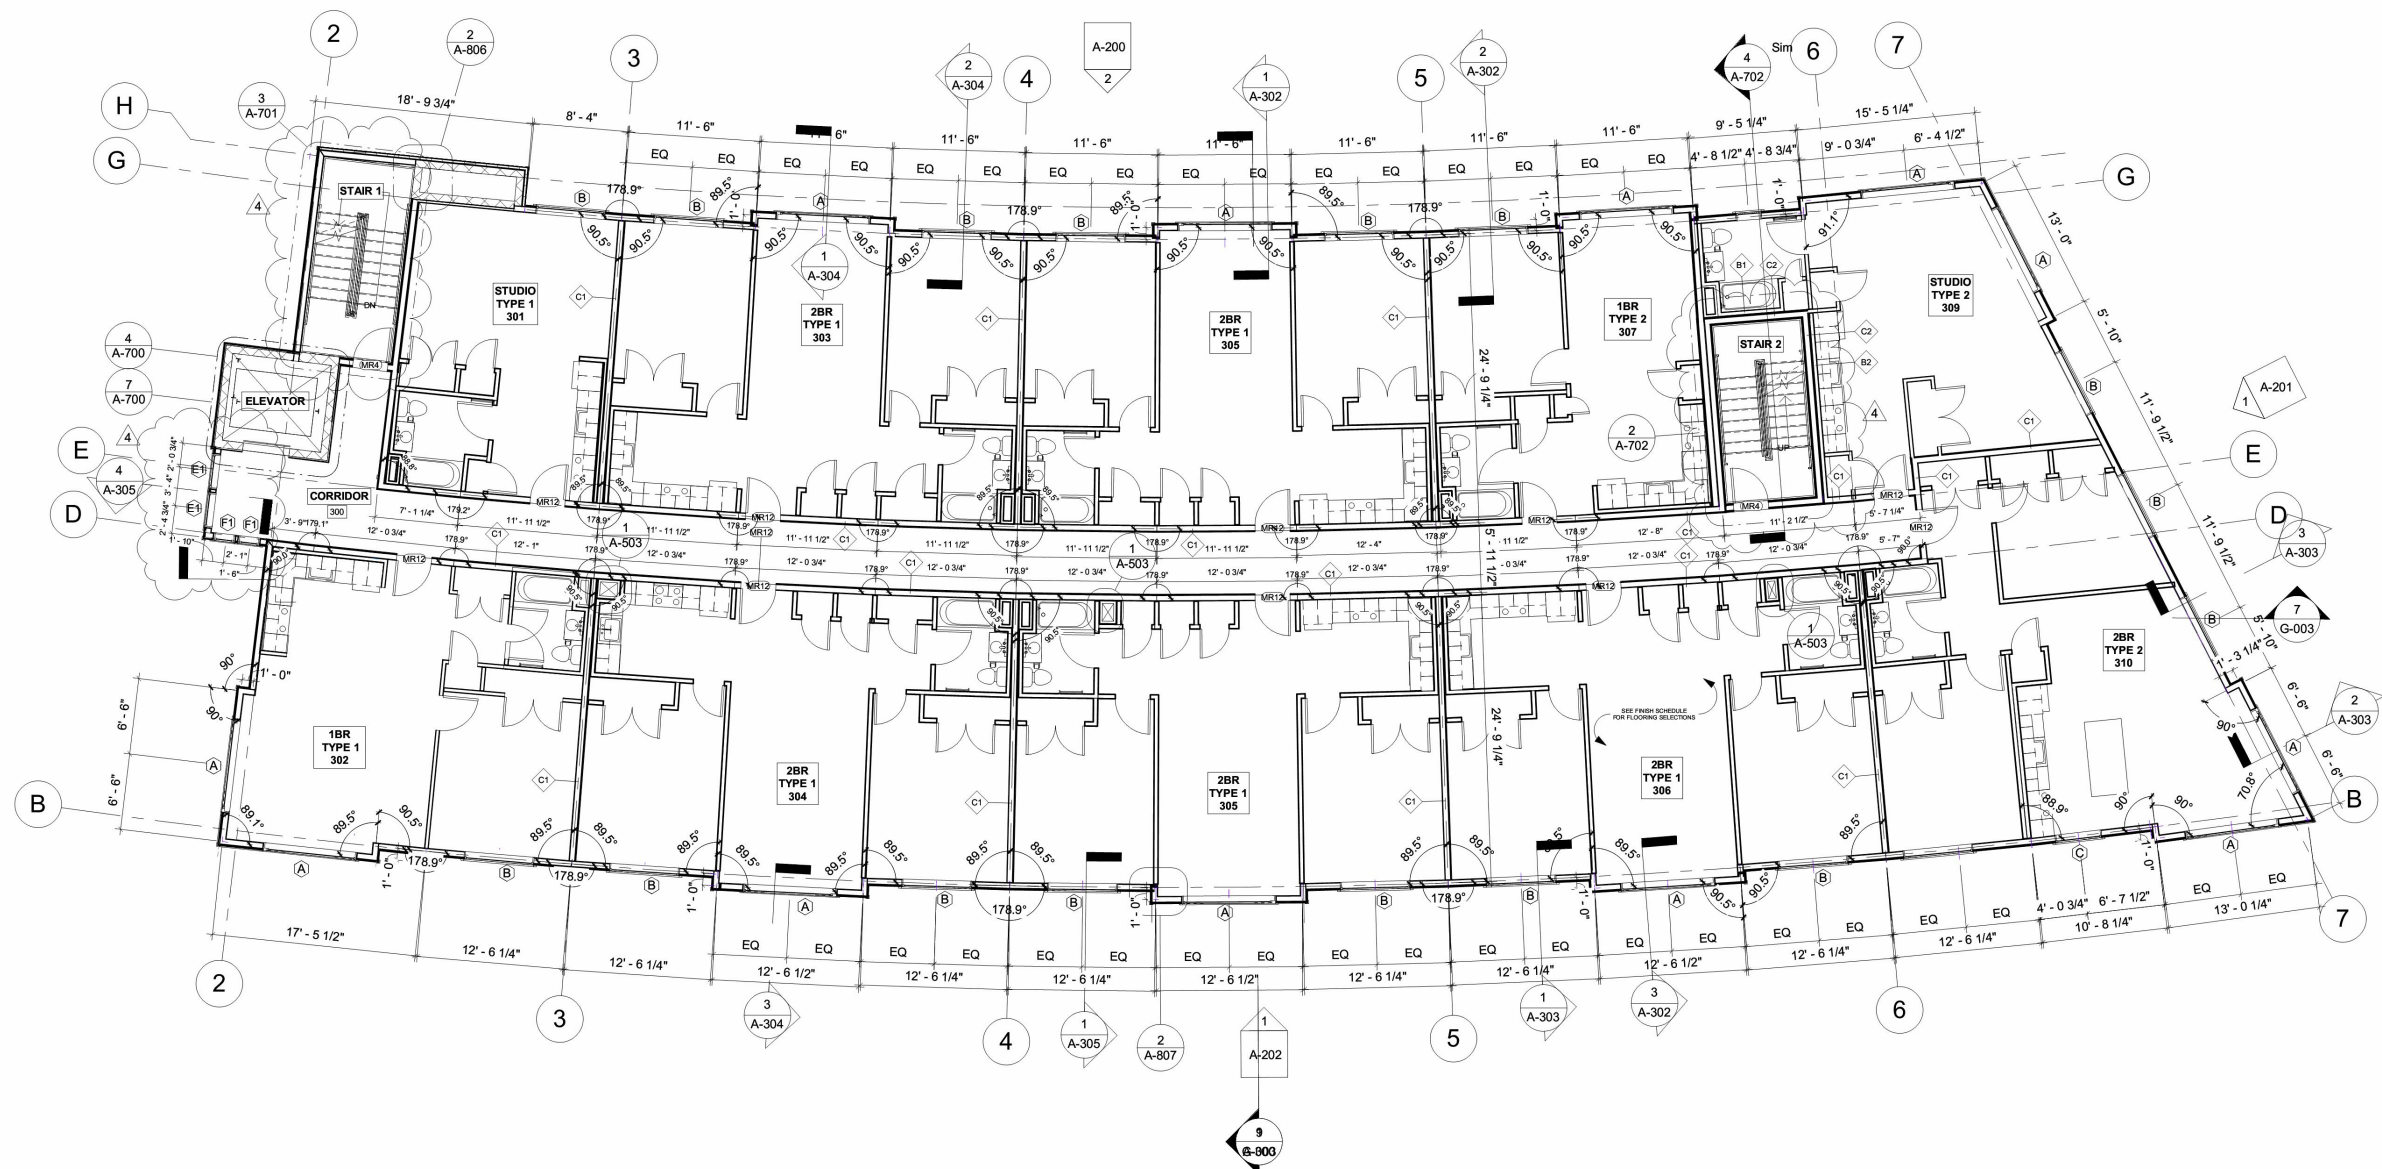

③ A4-THIRD FLOOR PLAN
1/8" = 1'-0"


WALL DIMENSIONING (UNLESS OTHERWISE NOTED)	
CENTERLINE DIMENSIONS	
STUD TO STUD DIMENSIONS	

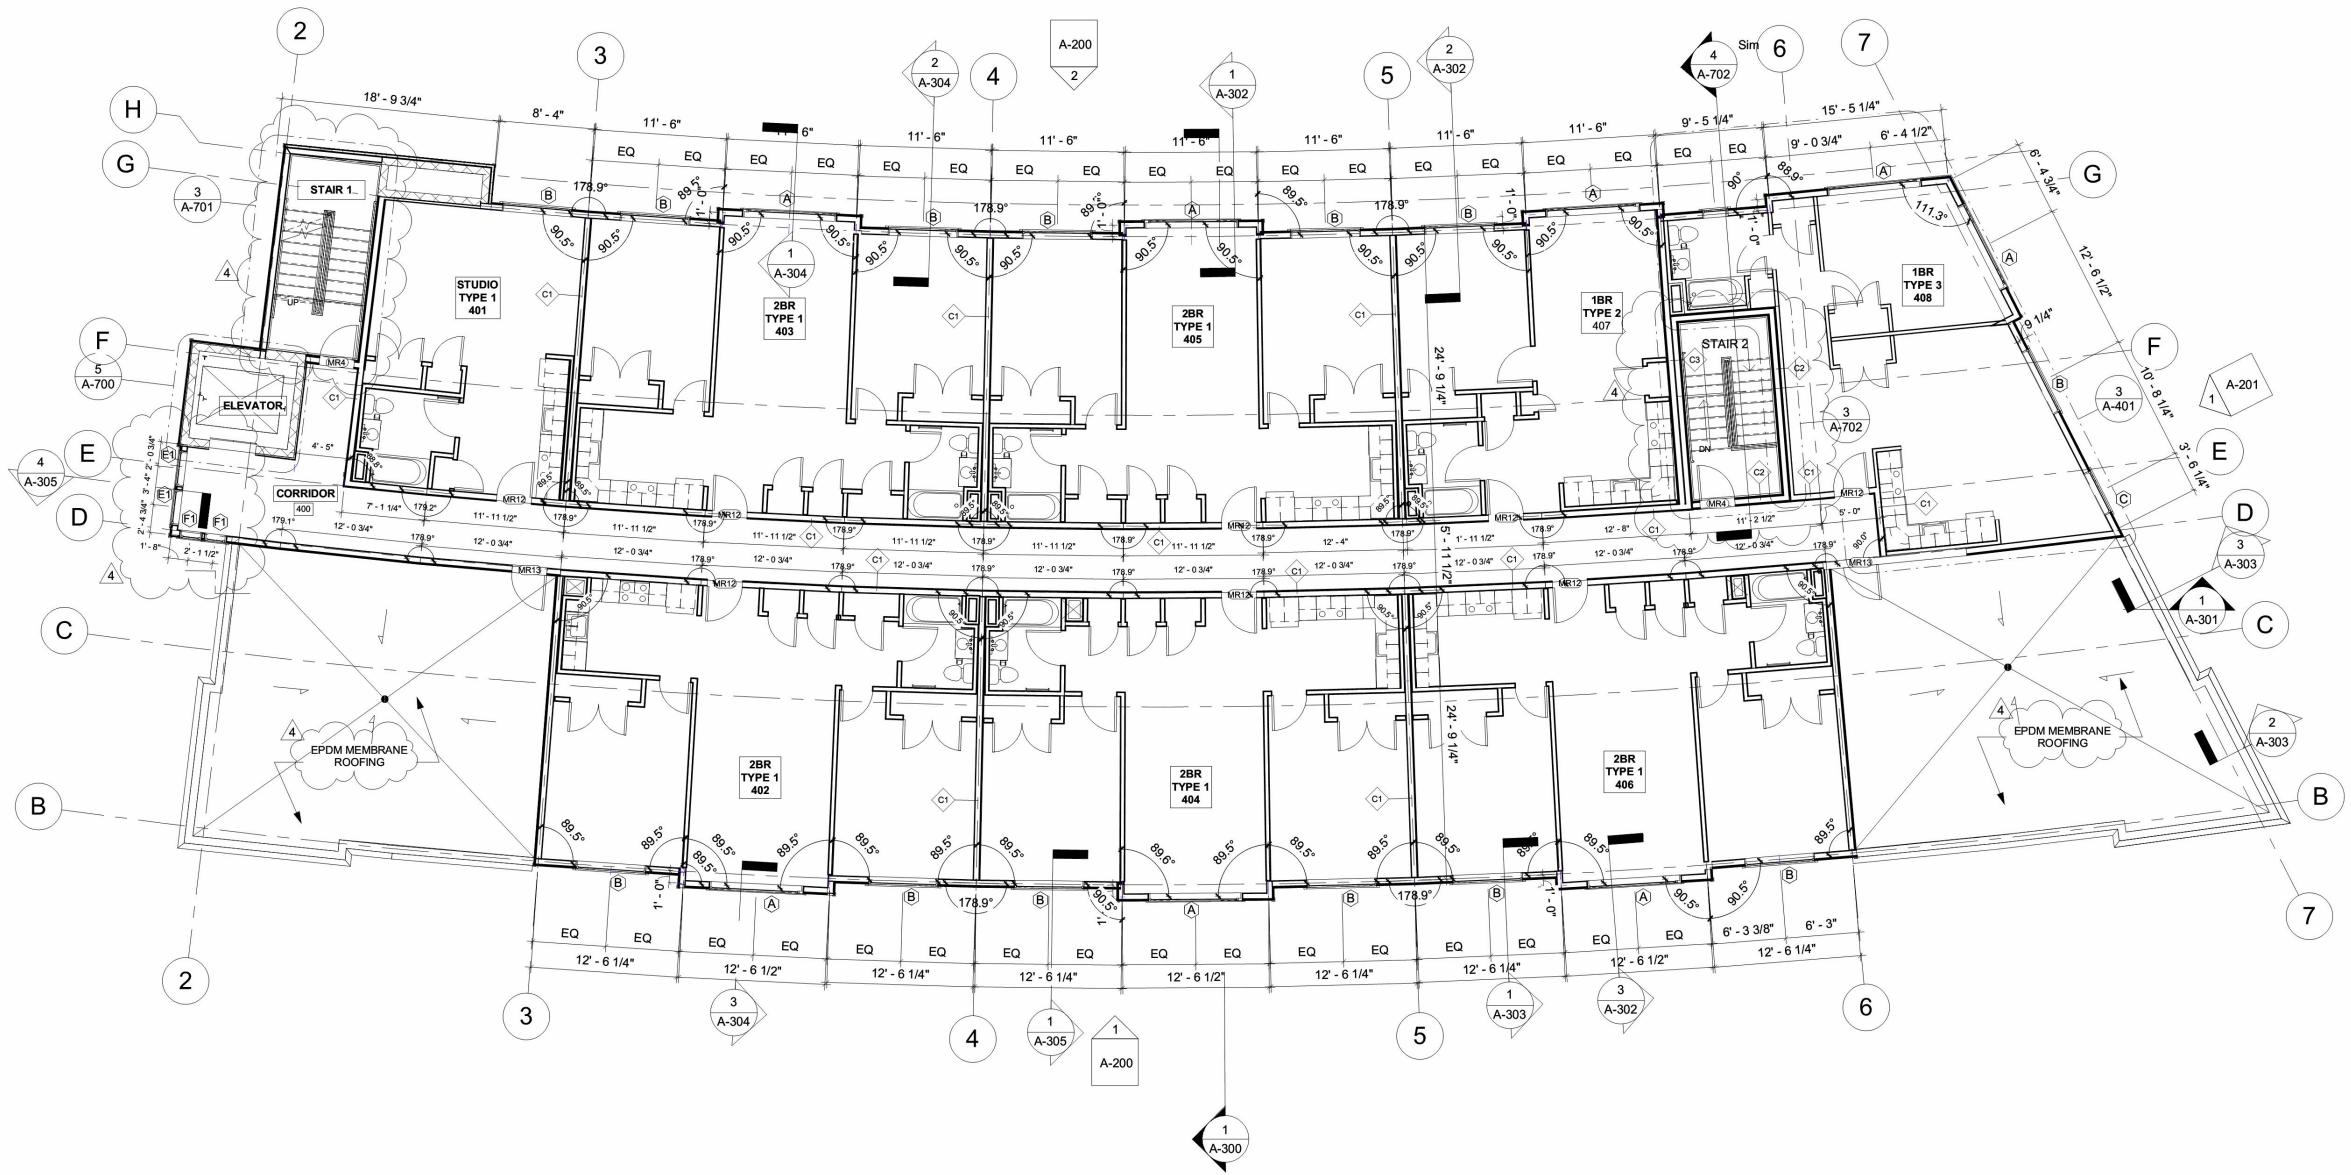

4 A5-FOURTH FLOOR PLAN
1/8" = 1'-0"





GENERAL NOTE:
ALL REFERENCES THROUGHOUT CONSTRUCTION DOCUMENTS REFERRING TO TPO ROOFING TO BE REPLACED WITH EPDM ROOFING MEMBRANE. SEE ADDITIONAL SPECIFICATION SECTION ADDED TO THE CONFORMED CONSTRUCTION DOCUMENTS

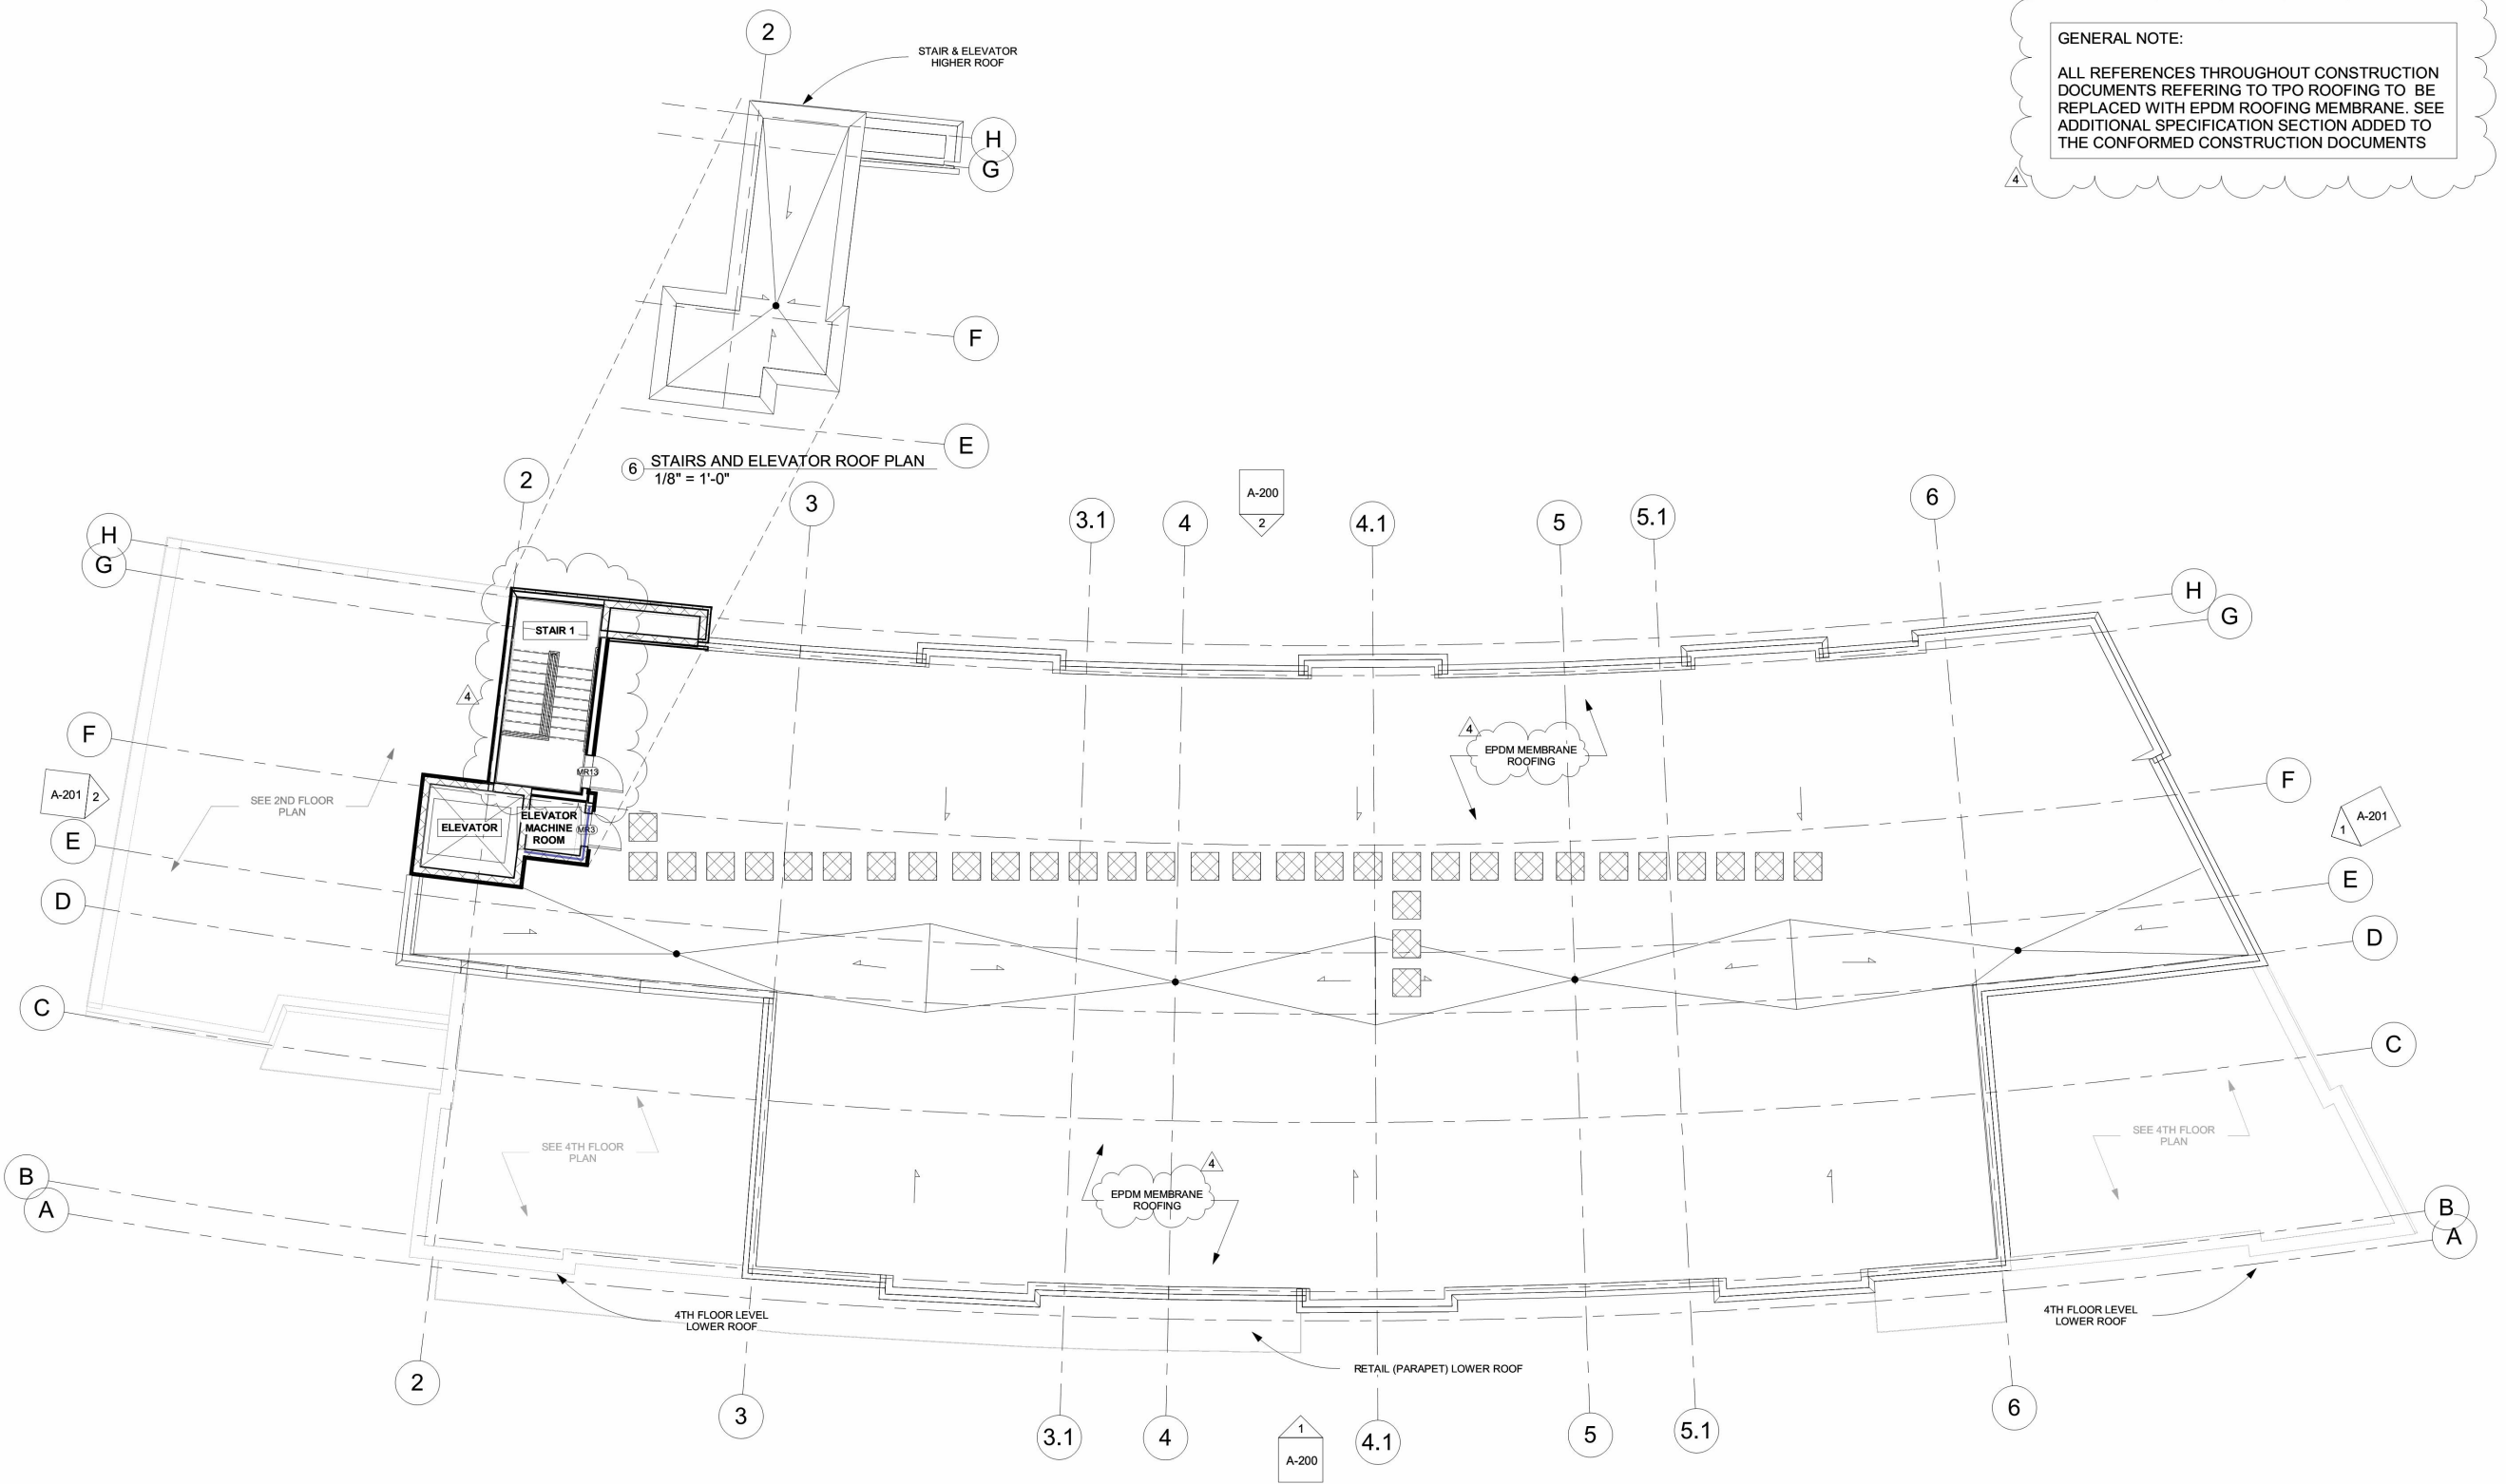

5 A6-ROOF PLAN
1/8" = 1'-0"


8" CMU, 11' High, 01 BB, Ded= 01 x (3 x 6.67') 10.2 FT

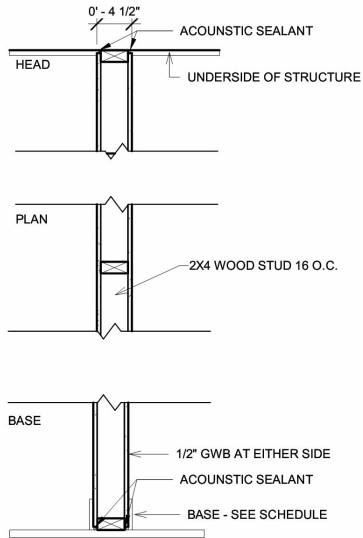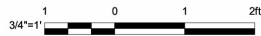


A 2x4 WOOD STUD INTERIOR PARTITION
1" = 1'-0"

A1 2x4 WOOD STUD INTERIOR PARTITION AT WET WALL
1" = 1'-0"
SAME AS TYPE A WITH THE FOLLOWING CHANGES:
SUBSTITUTE AT WET SIDE 1/2" GWB WITH 1/2" NON-PAPER FACED GWB.


A2 2x6 WOOD STUD INTERIOR PARTITION
1" = 1'-0"
SAME AS TYPE A1 WITH THE FOLLOWING CHANGES:
SUBSTITUTE 2x4 WOOD STUD WITH 2x6 WOOD STUD.

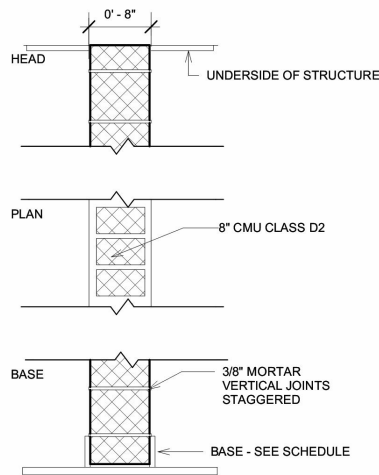


D CONCRETE MASONRY UNIT WALL
1" = 1'-0"

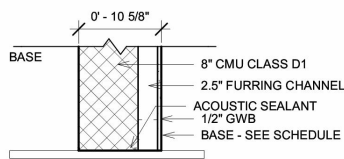


D1 FURRED CMU WALL
1" = 1'-0" 3HR RATED #U914

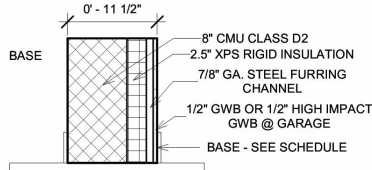

D2 INSULATED CMU WALL
1" = 1'-0" 3HR RATED #U912

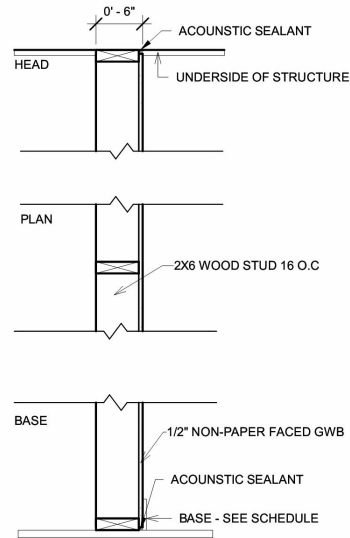


B 2x6 FURRED PARTITION AT WET WALL
1" = 1'-0"

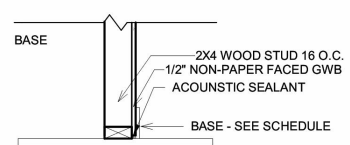


B1 2x4 FURRED PARTITION AT WET WALL
1" = 1'-0"


B2 2x4 FURRED PARTITION AT DRY WALL
1" = 1'-0"
SAME AS TYPE B1 WITH THE FOLLOWING CHANGES:
SUBSTITUTE 1/2" NON-PAPER FACED GWB WITH 1/2" GWB

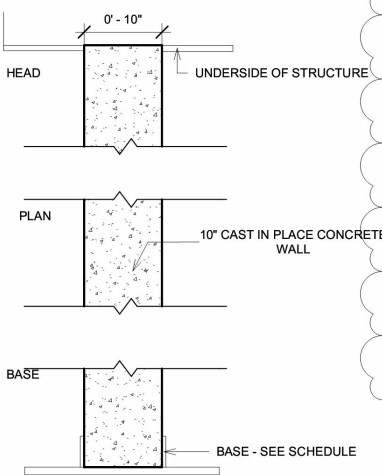


E CAST-IN-PLACE WALL
1" = 1'-0" 3HR RATED

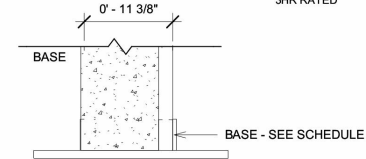

E1 FURRED CAST-IN-PLACE WALL
1" = 1'-0"

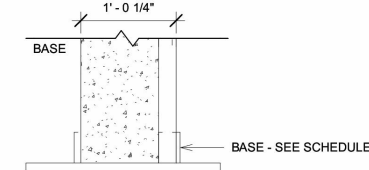


E2 INSULATED CONCRETE WALL
1" = 1'-0"

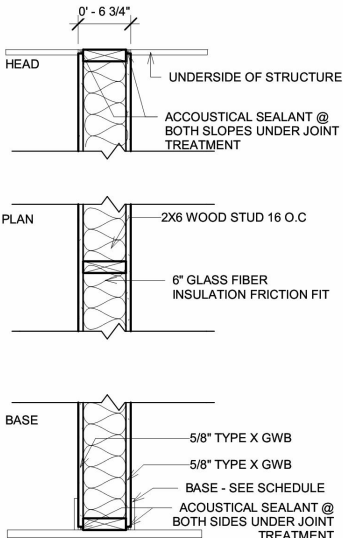


C UNIT DEMISING CORRIDOR PARTITION
1" = 1'-0" UL #U344 STC: 50


C1 UNIT DEMISING CORRIDOR SHEAR PARTITION
1" = 1'-0"
SAME AS TYPE F WITH THE FOLLOWING CHANGES:
ADD ONE LAYER OF 3/4" PLYWOOD, SHEATHING GRADE BETWEEN 2x6 WOOD STUD AND 5/8" TYPE X.

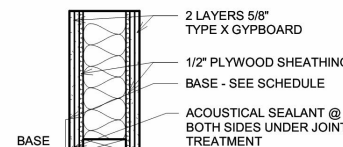





C2 STAIRWELL 2HR RATED SHAFT WALL - SHEAR
1" = 1'-0"
NOTE: SINGLE LAYER OF PLYWOOD SUFFICIENT FOR SHEAR. G.C. MAY OMIT ONE LAYER OF PLYWOOD

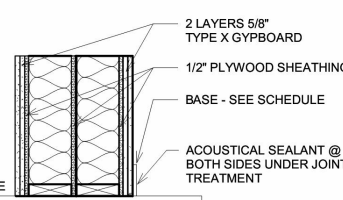


C3 STAIRWELL SHAFT WALL / DEMISING WALL 2HR RATED - SHEAR
1" = 1'-0"

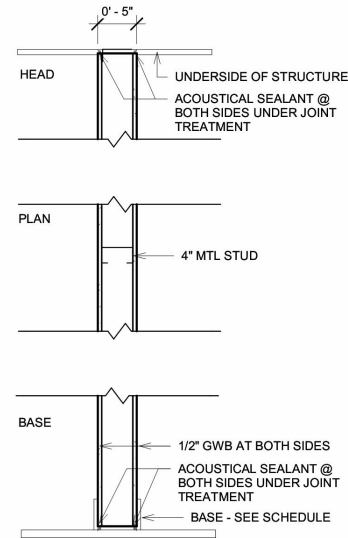


F 4" METAL STUD INTERIOR PARTITION
1" = 1'-0"

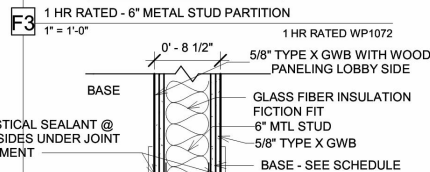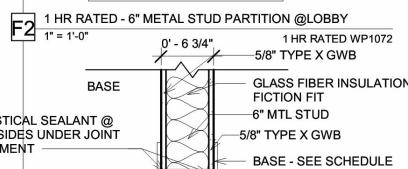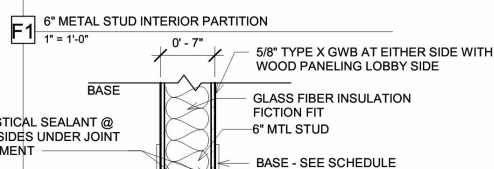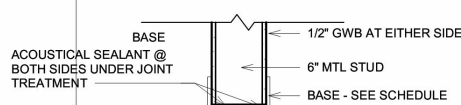


F4 2 HR RATED - 6" METAL STUD PARTITION @ MECH. RM.
1" = 1'-0" 2 HR RATED UL #U423

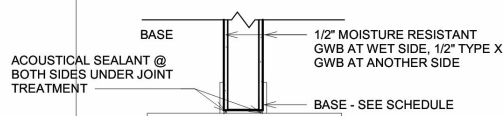

F5 4" METAL STUD INTERIOR PARTITION AT WET AREA
1" = 1'-0"

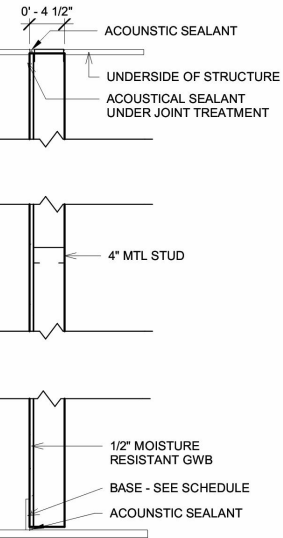

G 4" METAL STUD INTERIOR PARTITION
1" = 1'-0"

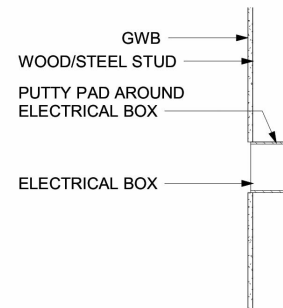

1 TYP. ELECTRICAL BOX SECTION DETAILS FOR ALL EXTERIOR, DEMISING AND CORRIDOR WALLS
1" = 1'-0"